



SEC. 24, TWP. 19N, R.7 E.

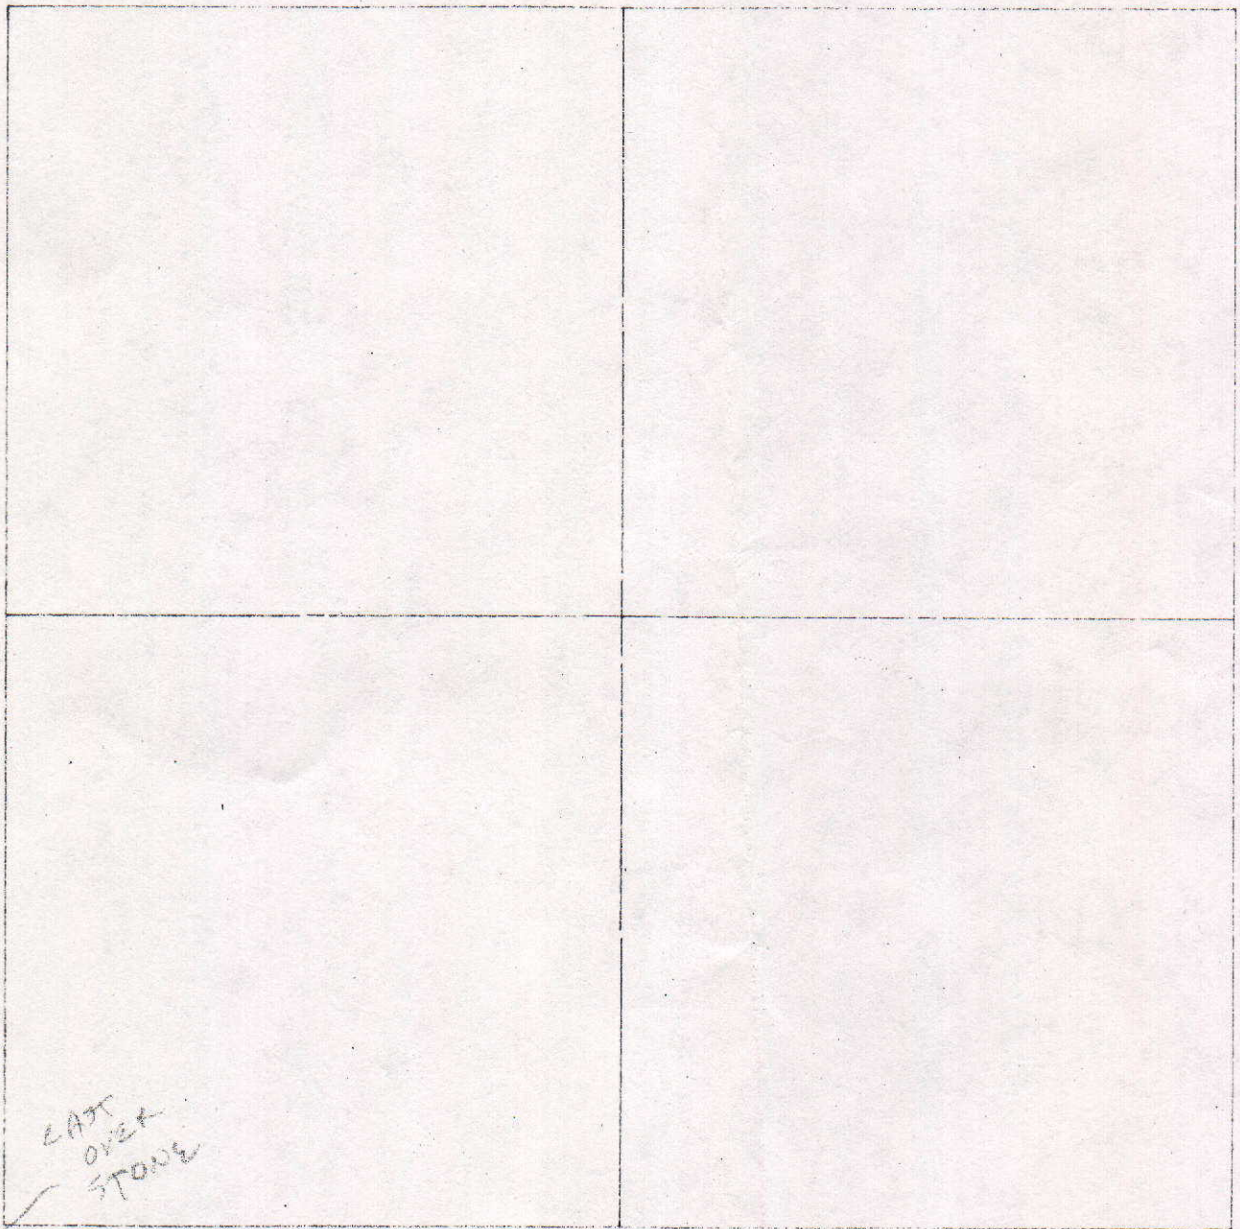

COUNTY SURVEYOR'S - SECTION CORNER TIES

SECTION	TOWNSHIP	RANGE	BOOK	PAGE	ELEVATION	UC ZONE	STATE PLANE COORD	LATITUDE	LONGITUDE
24	19N	7E				X =	Y =		


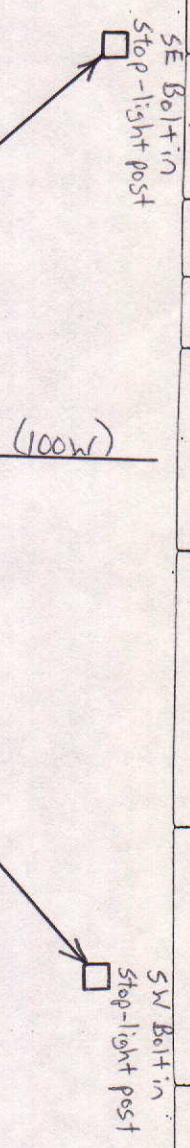


NORTH

SCALE 1" = 40'

Tied by: BAW Date: 3-25-93
 Drawn by: BAW Date: 3-26-93
 Checked by: _____ Date: _____

DESCRIPTION OF MONUMENT

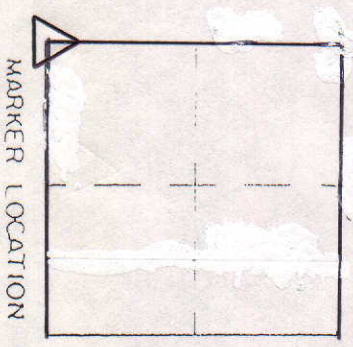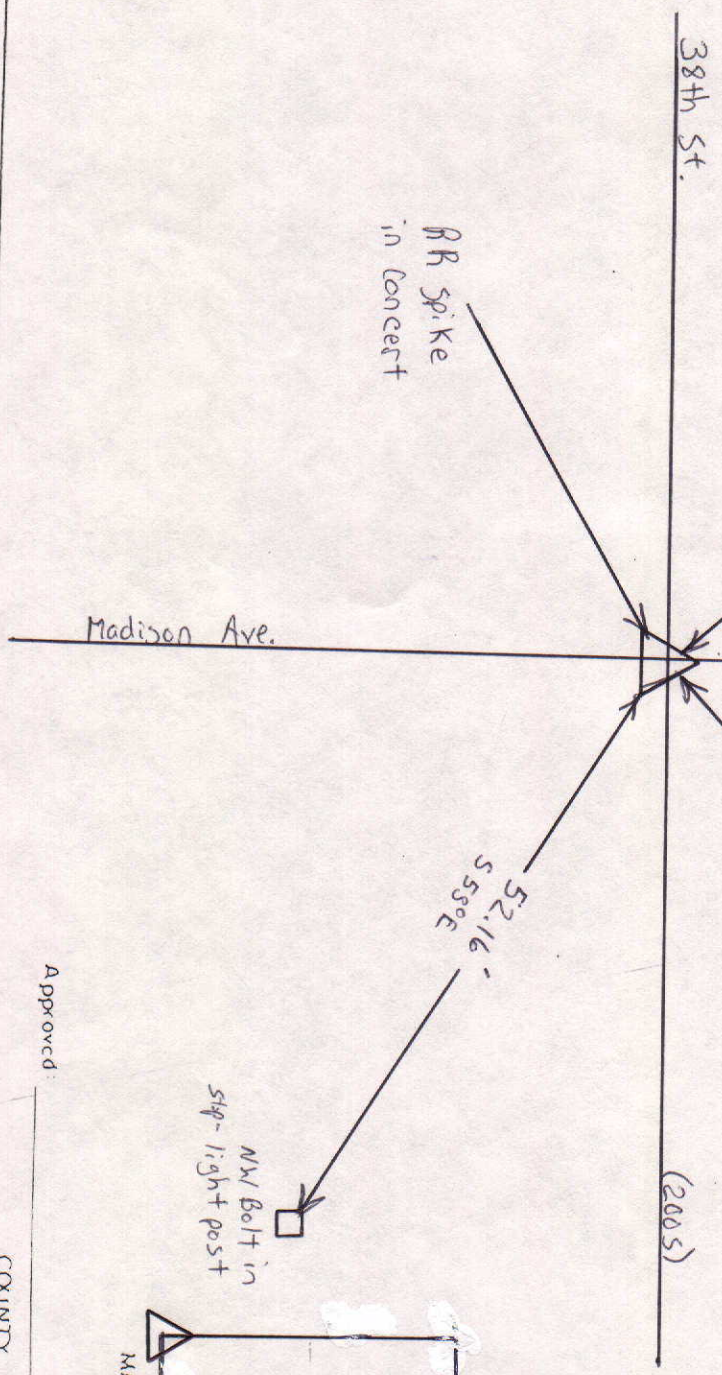

MARKER LOCATION

Approved: _____ Date: _____
 COUNTY SURVEYOR

COUNTY SURVEYOR'S - SECTION CORNER TIES

SECTION	TOWNSHIP	RANGE	BOOK	PAGE	ELEVATION	UC ZONE	STATE PLANE COORD	LATITUDE	LONGITUDE
24.	19	7				X=	Y=		



P.K. NAIL IN CENTER OF RAILROAD TRACKS

WALNUT ST.

5 IN. BOLT OF R.R. TRACK DROP AEN POST

DESCRIPTION OF MONUMENT

P.K. NAIL IN Center of RAILROAD TRACKS

Tied by: R. J. Mc Date: 10-1-03
Drawn by: RW Date: 11-6-03
Checked by: _____ Date: _____

N.E. CORNER of CASTLE FACTORY BUILDING

68.10'

50.05'

P.K. IN WEST SIDE OF T.P.

39.53'


P.K. NAIL IN EAST SIDE OF T.P.

41.71'

RAILROAD TRACKS

WALNUT ST.

MADISON AVE.

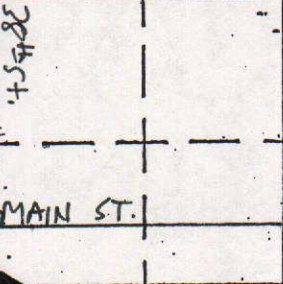

MARKER LOCATION


Approved: _____

Date: _____

COUNTY SURVEYOR

COUNTY SURVEYOR'S - SECTION CORNER TIES

SECTION	TOWNSHIP	RANGE	BOOK	PAGE	ELEVATION	UC ZONE	STATE PLANE COORD	LATITUDE	LONGITUDE
24	19N	7E				X=	Y=		

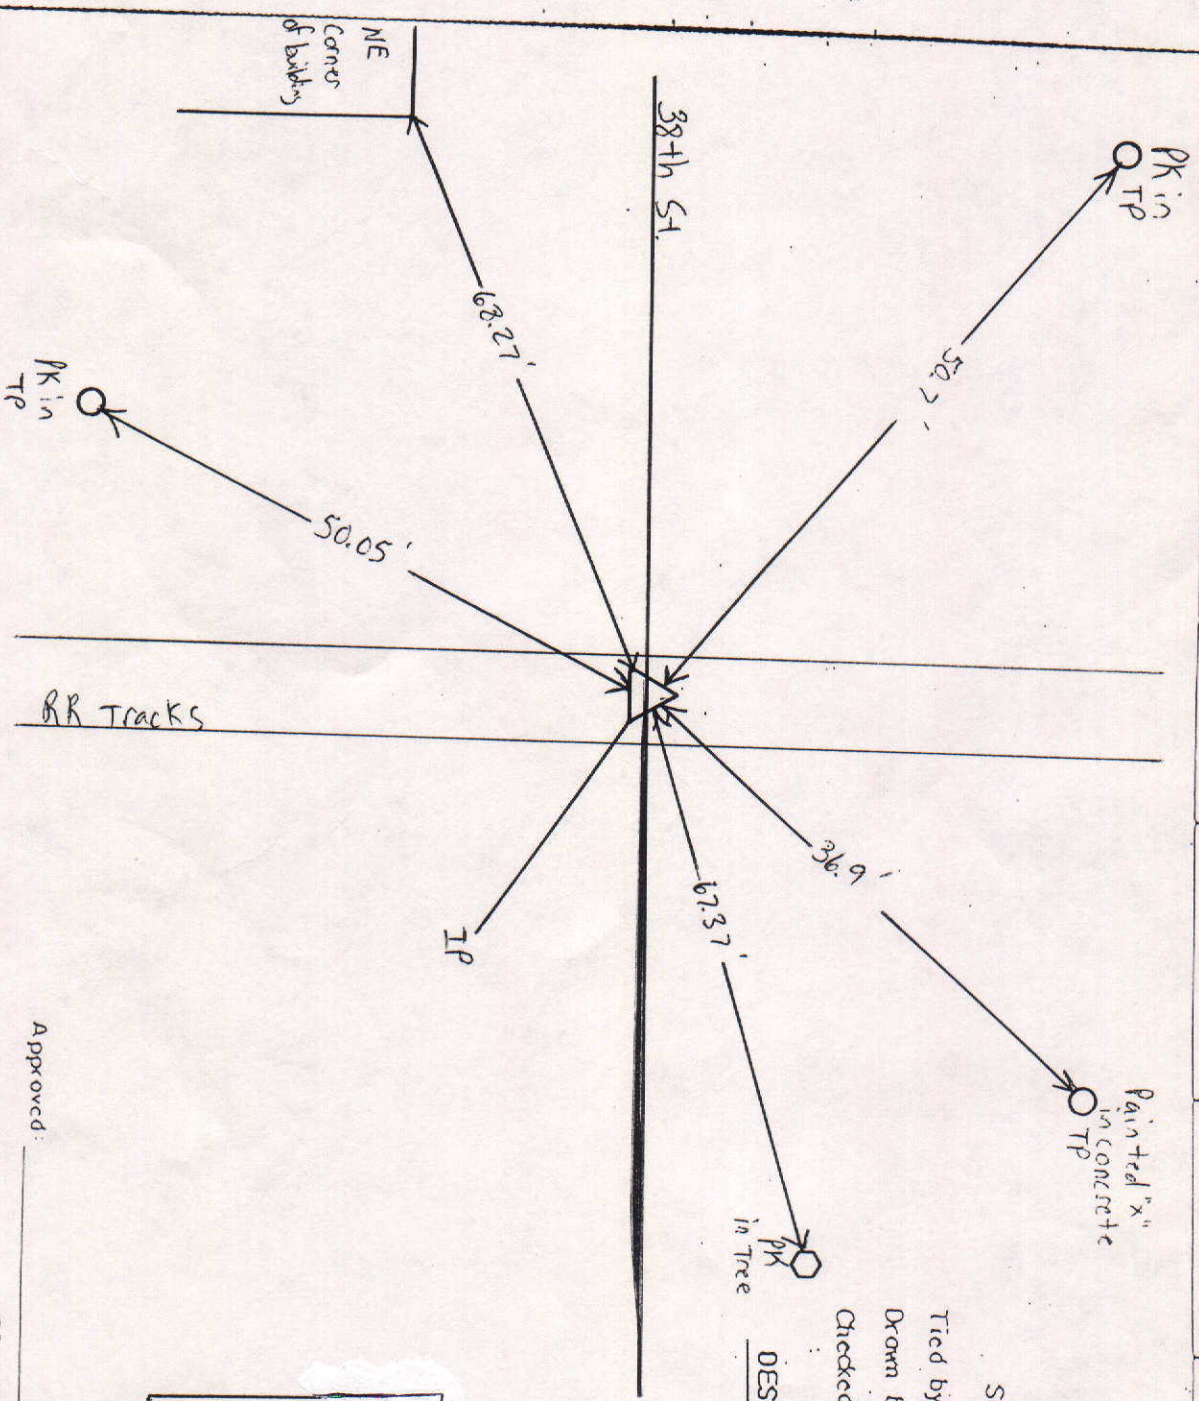

SCALE 1"=40'


SHEET ___ OF ___ SHEETS

Tied by: BAM/MF Date: _____

Drawn by: BAM Date: 1-29-93

Checked by: _____ Date: _____

DESCRIPTION OF MONUMENT

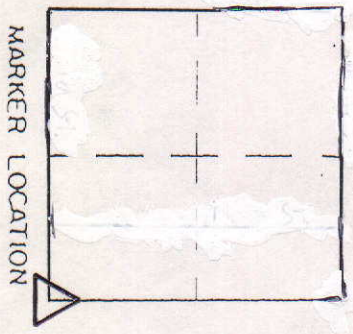


MARKER LOCATION

Approved: _____ Date: _____

COUNTY SURVEYOR

COUNTY SURVEYOR'S - SECTION CORNER TIES

SECTION	TOWNSHIP	RANGE	BOOK	PAGE	ELEVATION	UC ZONE	STATE PLANE COORD	LATITUDE	LONGITUDE
24	19N	7E				X =	Y =		

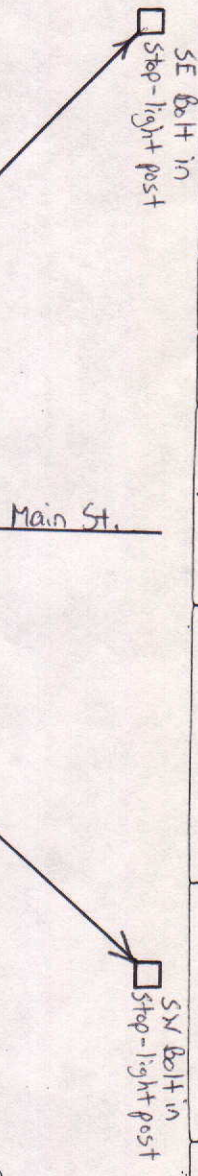

NORTH
SCALE 1" = 40'

SHEET ___ OF ___ SHEETS


Tied by: BAM: LM Date: 3-25-93
Drawn by: BAM Date: 3-26-93
Checked by: _____ Date: _____

DESCRIPTION OF MONUMENT

Iron Ripe
in concrete

38th St.
(2005)

Main St.

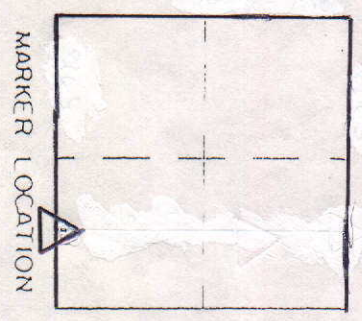

MARKER LOCATION

Approved: _____ Date: _____
COUNTY SURVEYOR

COUNTY SURVEYOR'S - SECTION CORNER TIES

SECTION	TOWNSHIP	RANGE	BOOK	PAGE	ELEVATION	UC ZONE	STATE PLANE COORD	LATITUDE	LONGITUDE
24	19N	7E				X=	Y=		

PK in
Apple Tree

88.80'

100W

Iron
Pipe

72.24'

PK in 30"
Tree (Hale Trunk)



NORTH

SCALE 1" = 40'


SHEET ___ OF ___ SHEETS

Tied by: _____ Date: _____

Drawn by: BAN Date: 3-23-93

Checked by: _____ Date: _____

DESCRIPTION OF MONUMENT

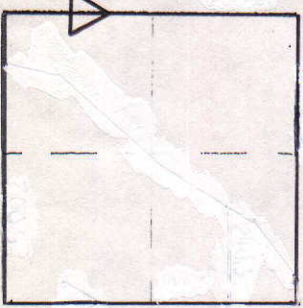


MARKER LOCATION

Approved: _____ Date: _____

COUNTY SURVEYOR

COUNTY SURVEYOR'S - SECTION CORNER TIES


SECTION	TOWNSHIP	RANGE	BOOK	PAGE	ELEVATION	UC ZONE	STATE PLANE COORD	LATITUDE	LONGITUDE
24	19N	7E				X=	Y=		

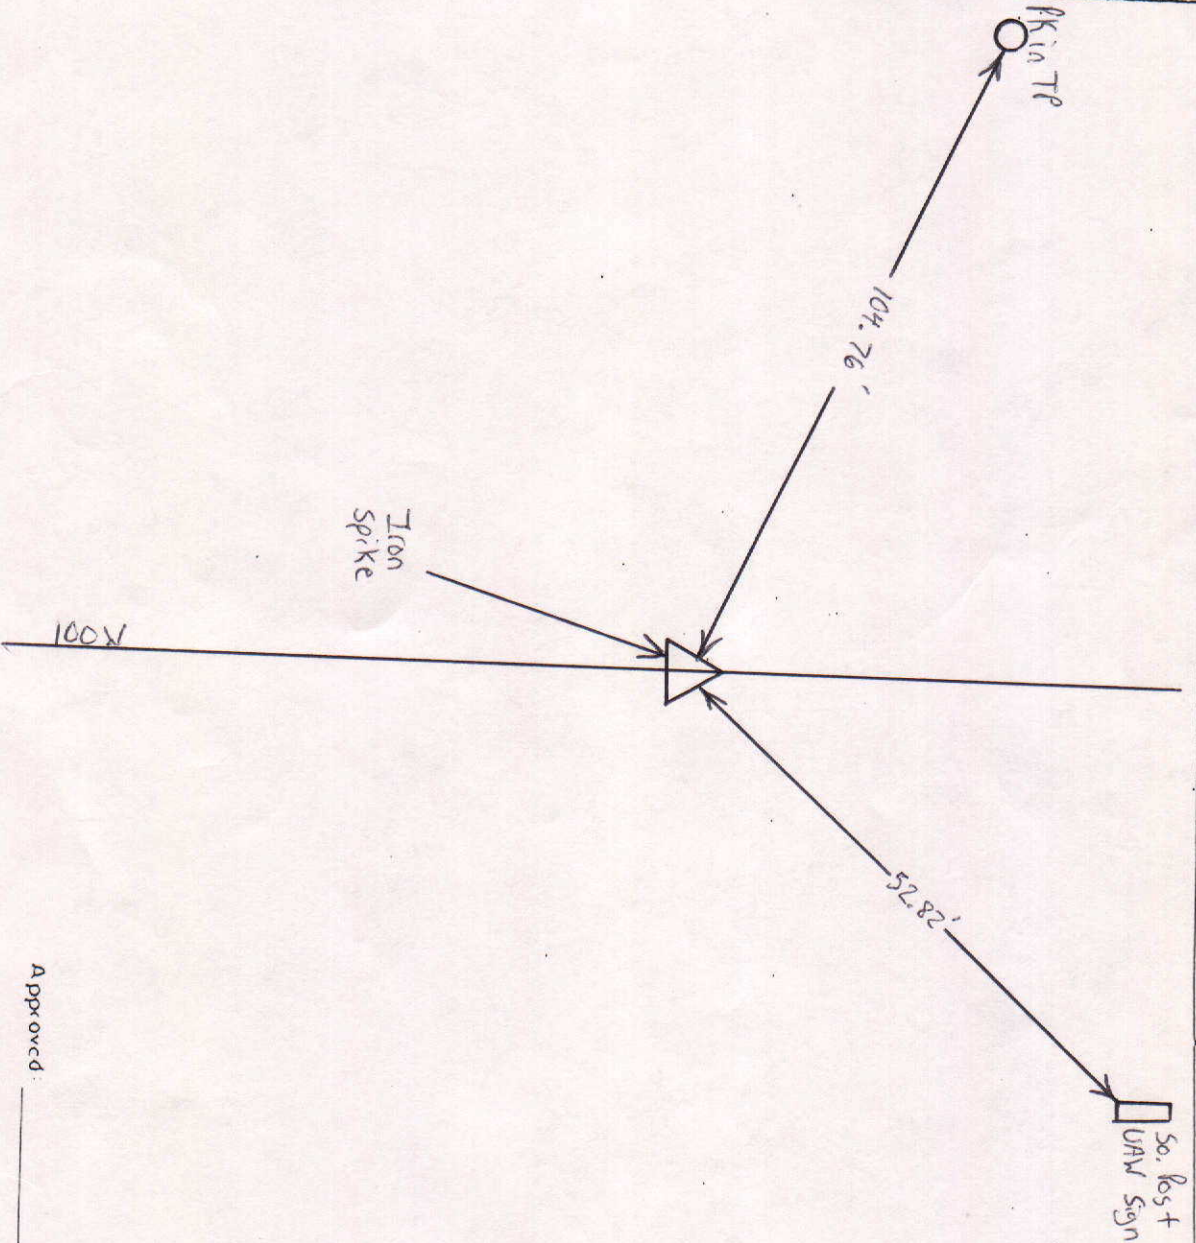

NORTH
SCALE 1" = 40'
SHEET ___ OF ___ SHEETS

Tied by: _____ Date: _____
 Drawn by: BAN _____ Date: 3-23-93
 Checked by: _____ Date: _____

DESCRIPTION OF MONUMENT

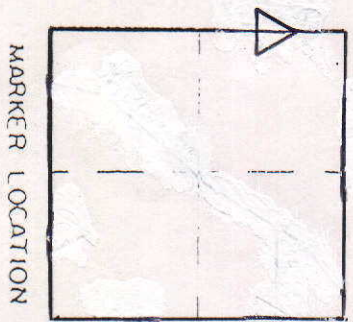

MARKER LOCATION

Approved: _____ Date: _____
 COUNTY SURVEYOR

COUNTY SURVEYOR'S - SECTION CORNER TIES

SECTION	TOWNSHIP	RANGE	BOOK	PAGE	ELEVATION	UC ZONE	STATE PLANE COORD	LATITUDE	LONGITUDE
24.	19	7				X=	Y=		

P.K. NAIL IN EAST SIDE OF T.P.

70.06'

37.92'

30.78'

P.K. NAIL

P.K. NAIL IN S.W. SIDE OF P.P.

1" up on S.W. corner of "WISHING WELL" RESTAURANT

Tied by: RW/ME Date: 10-1-03
 Drawn by: RW Date: 11-6-03

Checked by: _____ Date: _____


DESCRIPTION OF MONUMENT

P.K. NAIL FLUSH w/Asphalt Road



FAIRVIEW ST.

29th St.

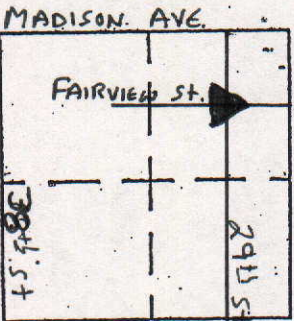

MARKER LOCATION


Approved: _____ Date: _____

COUNTY SURVEYOR'S - SECTION CORNER TIES

SECTION	TOWNSHIP	RANGE	BOOK	PAGE	ELEVATION	UC ZONE	STATE PLANE COORD	LATITUDE	LONGITUDE
24	19	7				X=	Y=		



NORTH

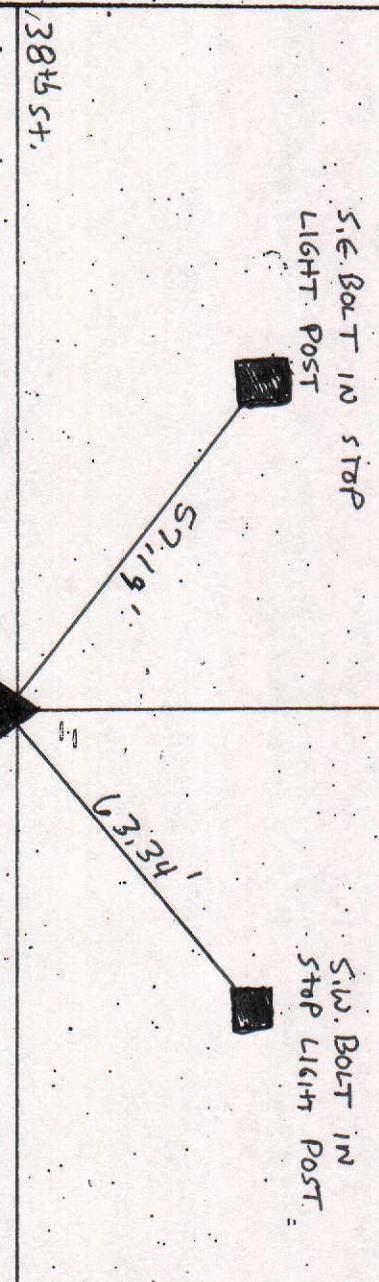


DESCRIPTION OF MONUMENT

Iron Pipe in Concrete

Tied by: Rw/mc Date: 10-1-03

Drawn by: Rw Date: 11-6-03

Checked by: _____ Date: _____

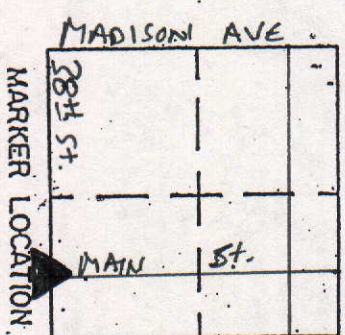

Approved: _____ Date: _____

COUNTY SURVEYOR'S - SECTION CORNER TIES

SECTION	TOWNSHIP	RANGE	BOOK	PAGE	ELEVATION	UC ZONE	STATE PLANE COORD	LATITUDE	LONGITUDE
24	19	7					X=	Y=	

NORTH



S.E. BOLT ON
LIGHT POST

S.W. BOLT IN
LIGHT POST

35.93-

54.47-

52.16-

RAILROAD SPIKE

N.W. BOLT IN
LIGHT POST

38th St.

DESCRIPTION OF MONUMENT

Railroad spike in
Concrete


Tied by: RW/MC Date: 10-1-03

Drawn by: RW Date: 11-6-03

Checked by: _____ Date: _____

MADISON AVE

Approved: _____ Date: _____

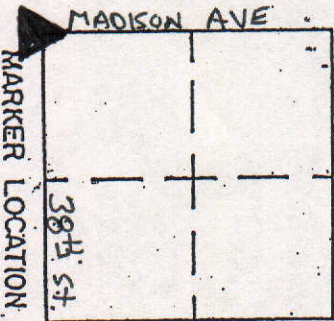

COUNTY SURVEYOR'S - SECTION CORNER TIES									
SECTION	TOWNSHIP	RANGE	BOOK	PAGE	ELEVATION	UC ZONE STATE PLANE COORD		LATITUDE	LONGITUDE
24	19	7				X=	Y=		



P.K. NAIL IN WEST
SIDE OF LIGHT POLE

147.00'

77.26'


P.K. NAIL FLUSH
W/ ASPHALT ROAD

P.K. NAIL IN
SOUTH SIDE
OF T.P.

MADISON AVE

Tied by: RW/me Date: 10-1-03
 Drawn by: RW Date: 11-6-03
 Checked by: _____ Date: _____

DESCRIPTION OF MONUMENT
 P.K. NAIL-FLUSH W/ ASPHALT ROAD
 (MAY NOT BE OVER STONE) (ALL
 PREVIOUS REFERENCE POINTS
 ARE NOW-EXISTANT)

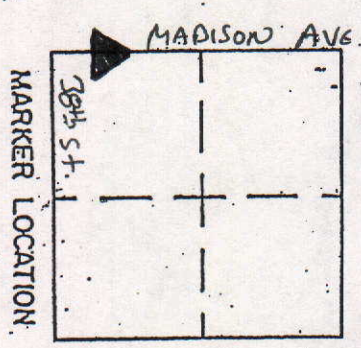

Approved: _____ Date: _____

COUNTY SURVEYOR'S - SECTION CORNER TIES

SECTION	TOWNSHIP	RANGE	BOOK	PAGE	ELEVATION	UC ZONE	STATE PLANE COORD	LATITUDE	LONGITUDE
24	19	7				X=	Y=		



P.K. NAIL IN NORTHWEST
SIDE OF T.P.

P.K. NAIL IN NORTH
SIDE OF T.P.

49.48'

53.03'

29th St.

Iron Pipe

MADISON AVE.


DESCRIPTION OF MONUMENT

Iron Pipe, 3" Below Casting,
3' Below Asphalt Road

Tied by: RW/MC Date: 10-1-03

Drawn by: RW Date: 11-6-03

Checked by: _____ Date: _____

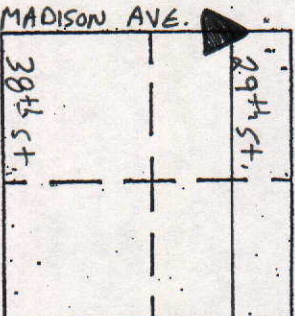

MARKER LOCATION

Approved: _____ Date: _____

RAYL

SURVEYING &
ENGINEERING, INC.

1940 EAST 53rd STREET
ANDERSON, INDIANA 46013
PH. (765) 643-5614

TRANSMITTAL

TO: Patrick Manship
Madison County Surveyor

FROM: Penny A. Narum

PROJECT: Section Corner Ties for the N.E. Corner of the N.W. 1/4 of
Section 24-T19N-R7e (S.E. Corner S.W. 1/4 of Section 13-T19N-R7E)

REGARDING: Current Rayl Field Ties

DATE: November 20, 2000

SHIPPED: Hand Delivered

WE ARE SENDING YOU:

SURVEY
PRINTS
SPECIFICATIONS
LEGAL DESC.

X

ATTACHED
UNDER SEPARATE COVER
DISK
OTHER

DESCRIPTION: Please find enclosed one copy each of the above referenced 1/4 corners.


TRANSMITTED:

X FOR APPROVAL
FOR YOUR USE
AS REQUESTED

FOR REVIEW AND COMMENT
APPROVED AS SUBMITTED
APPROVED AS NOTED

REMARKS:


THANK YOU,

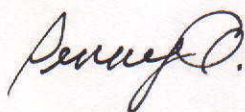


FILED: F:\LP2\1117\LETTERS\MADCOI.WPD\

LAND SURVEYORS CIVIL ENGINEERS
FAX: (765) 643-1874 E-MAIL: RSE@NETDIRECT.NET

ASSUMED
NORTH

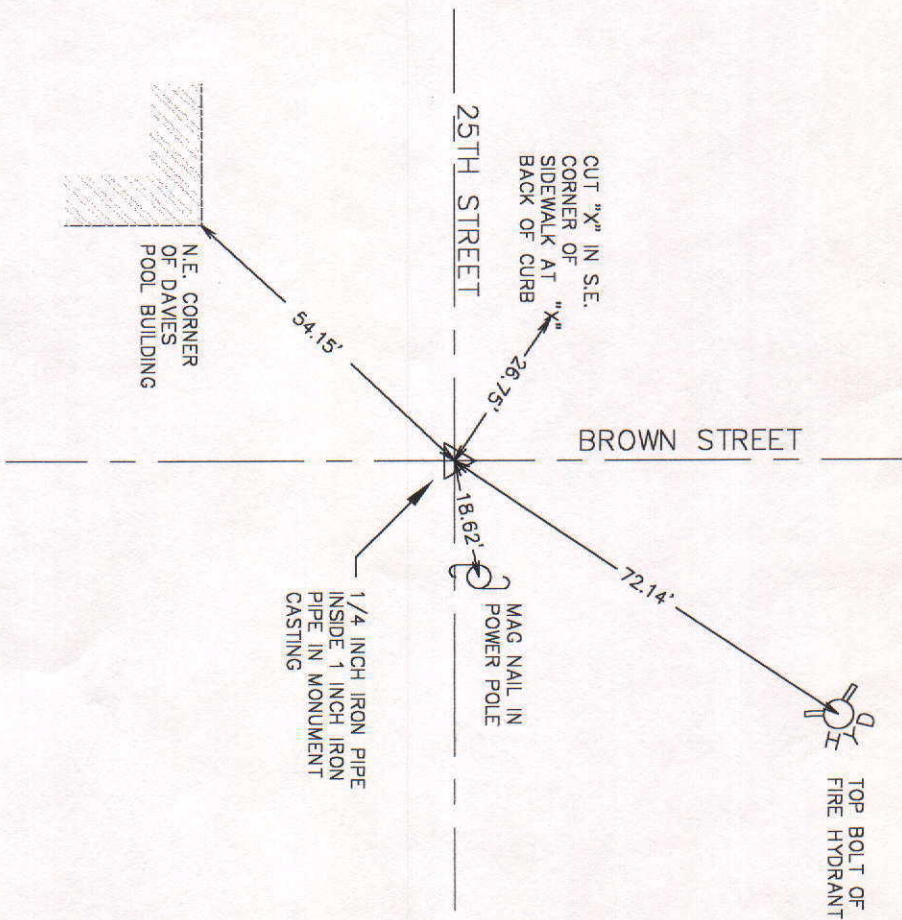

SECTION CORNER TIES MADE BY
RAYL SURVEYING & ENGINEERING, INC.
NOVEMBER 16, 2000
F.B. #184, P. 117

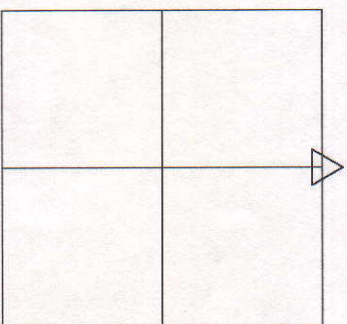

SECTION 24-T19N-R7E