


SEC. 25, TWP. 18 N, R. 6 E.

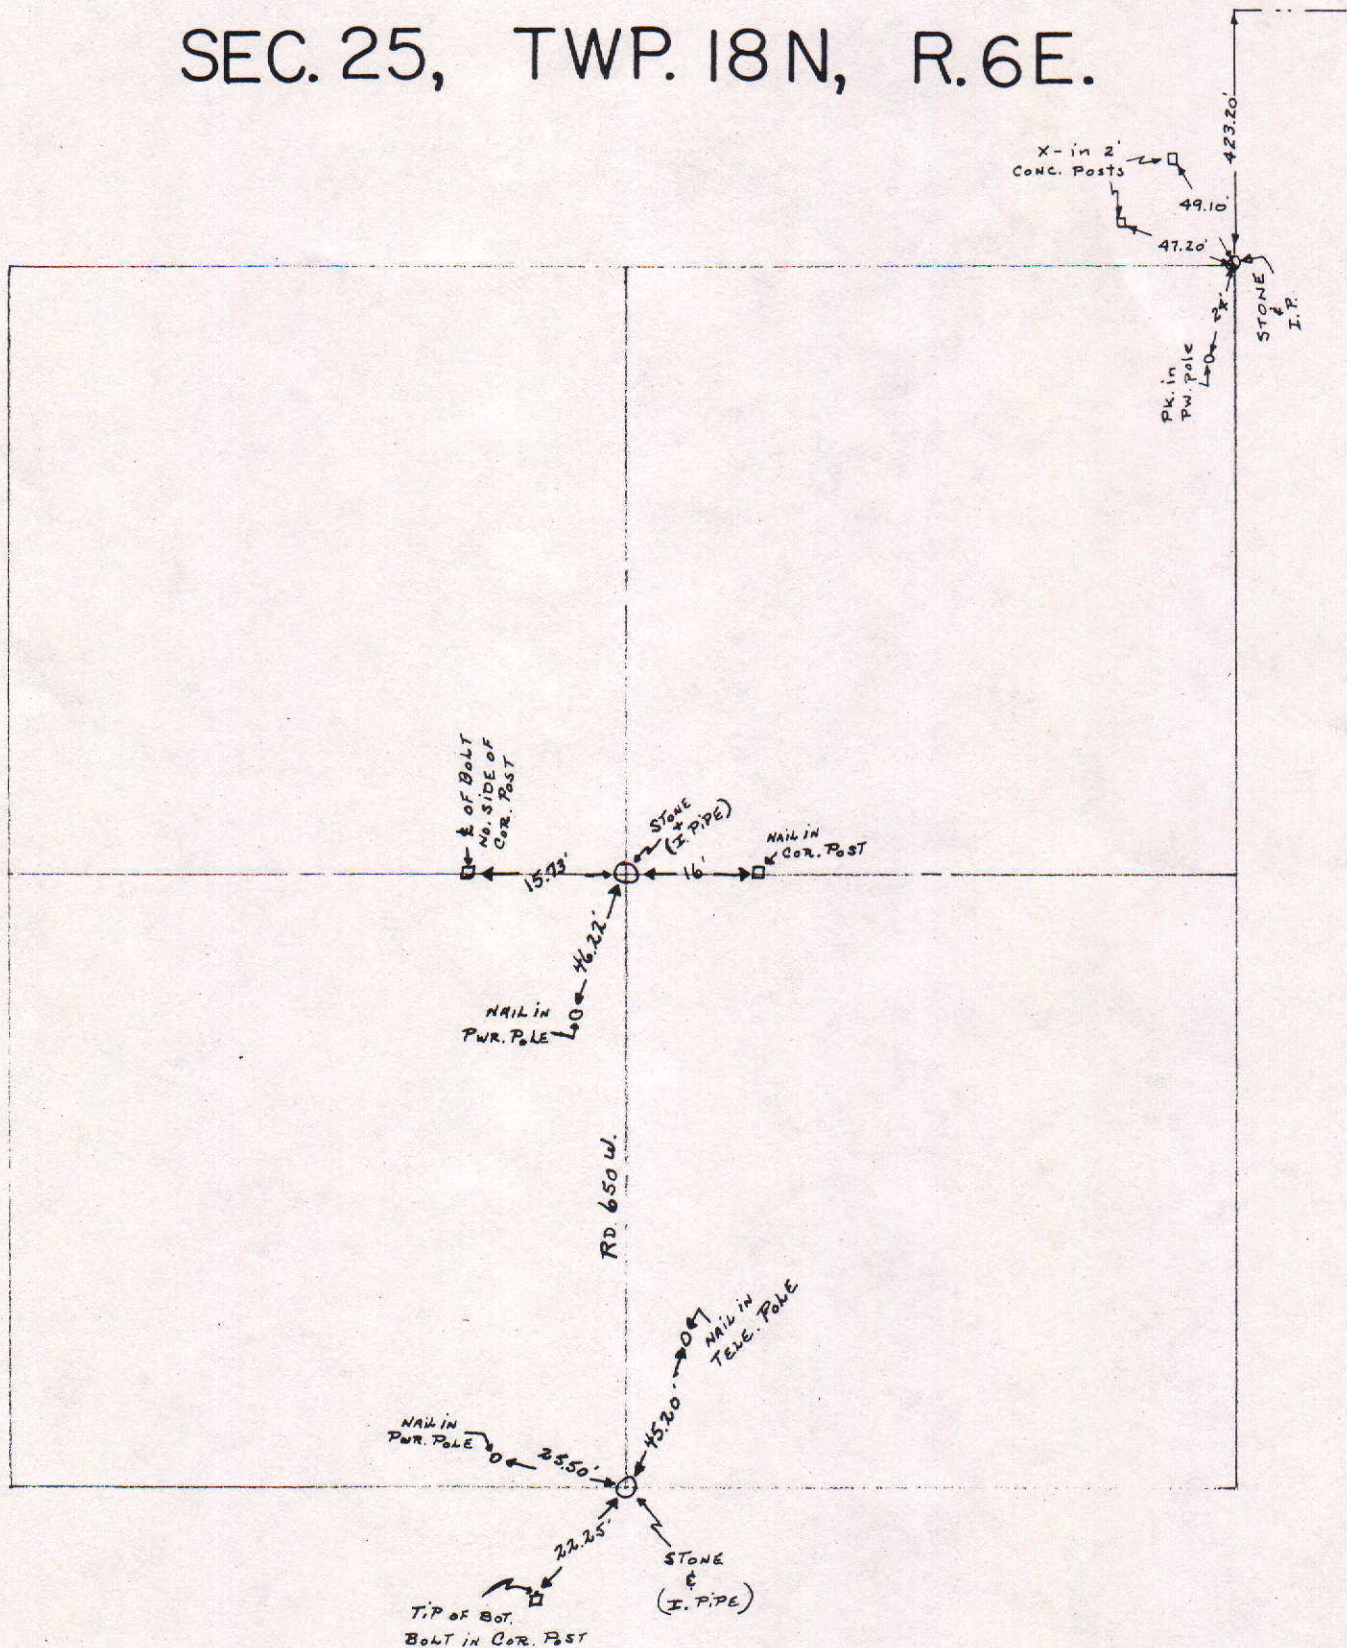

COUNTY SURVEYOR'S - SECTION CORNER TIES

SECTION	TOWNSHIP	RANGE	BOOK	PAGE	ELEVATION	UC ZONE	STATE PLANE COORD	LATITUDE	LONGITUDE
25	18N	6E					X= Y=		



SCALE 1" = 40'



SHEET ___ OF ___ SHEETS

Tied by: BAN:DM Date: 4-7-93

Drawn by: BAN Date: 4-13-93

Checked by: _____ Date: _____

DESCRIPTION OF MONUMENT

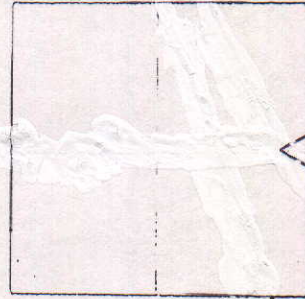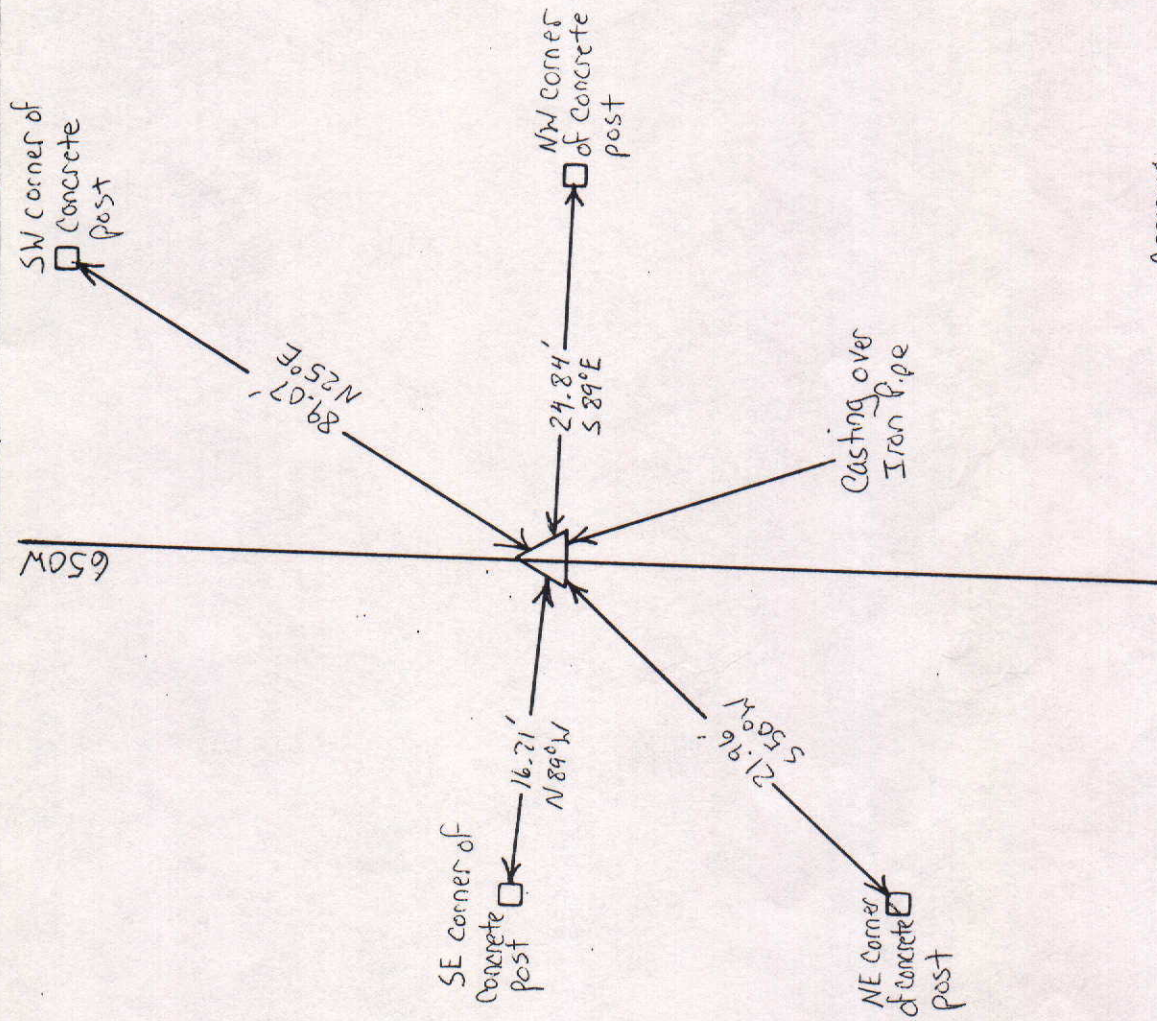

MARKER LOCATION

Approved _____

Date: _____

COUNTY SURVEYOR

COUNTY SURVEYOR'S - SECTION CORNER TIES

SECTION	TOWNSHIP	RANGE	BOOK	PAGE	ELEVATION	UC ZONE	STATE PLANE COORD	LATITUDE	LONGITUDE
25	18N	6E				X=	Y=		



NORTH

SCALE 1" = 40'

SHEET ___ OF ___ SHEETS



Tied by: L.P. i. BAN Date: 1/31/95 (12:30PM)

Drawn by: BAN Date: 5/4/95 (2:55PM)

Checked by: _____ Date: _____

DESCRIPTION OF MONUMENT

18"x18" concrete post, 5' above surface of natural ground; 2' south of 24" diameter tree; 8' North of 2" diameter tree; 20' East of 6" diameter tree; 40' West of 2' wide ladder crossing East-West Fence

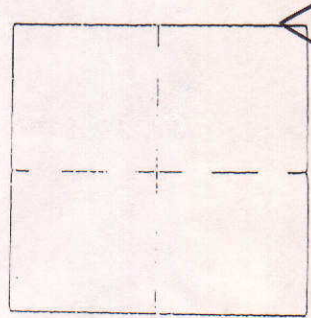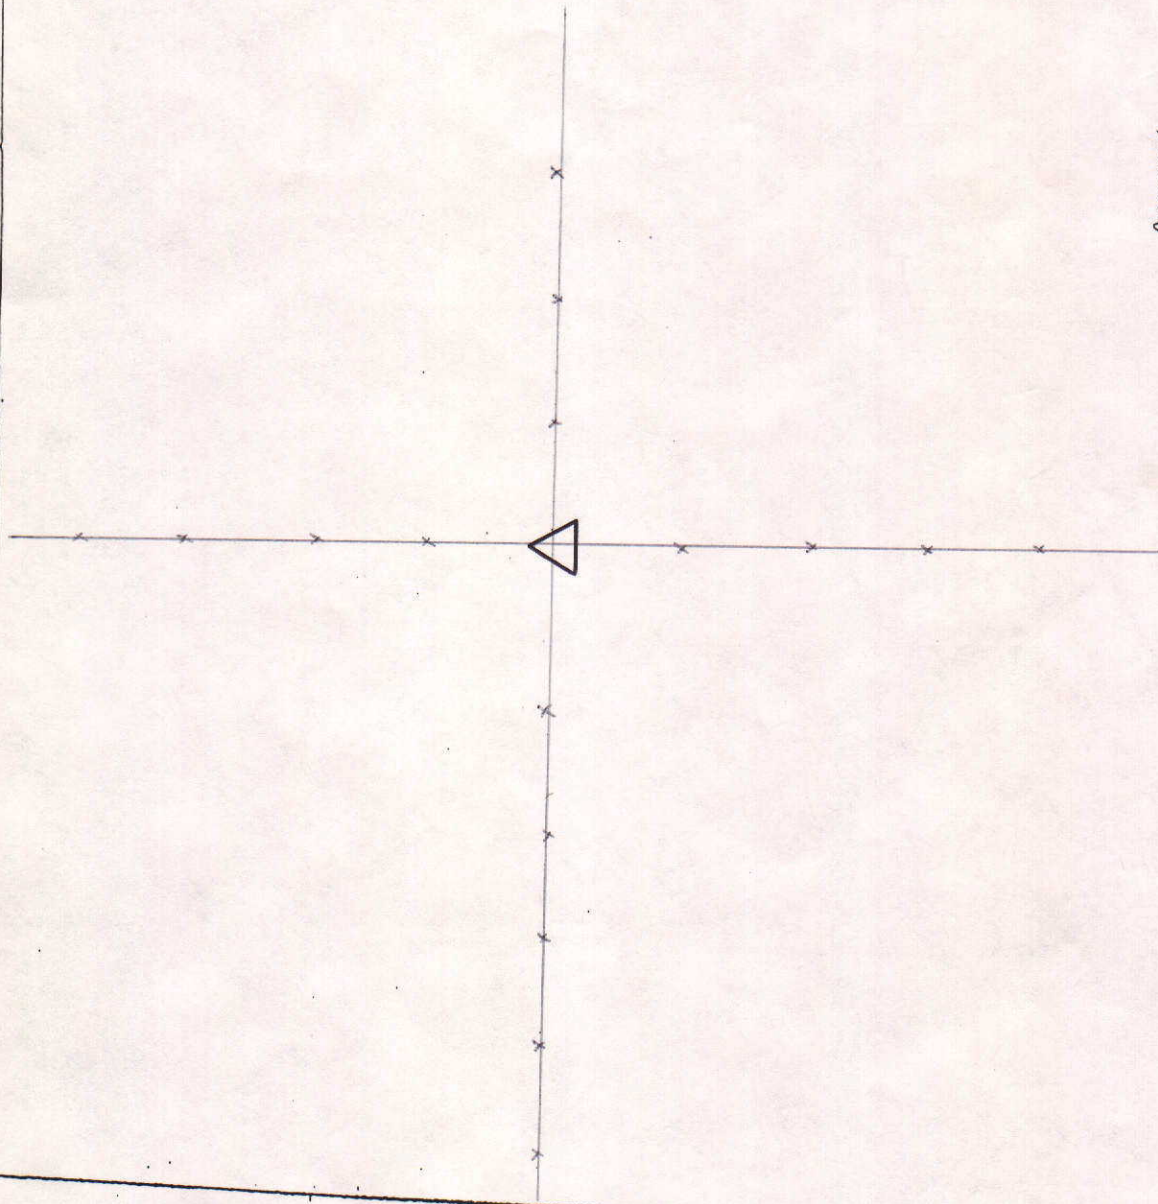

MARKER LOCATION

Approved _____

Date: _____

COUNTY SURVEYOR

COUNTY SURVEYOR'S - SECTION CORNER TIES

SECTION	TOWNSHIP	RANGE	BOOK	PAGE	ELEVATION	UC ZONE	STATE PLANE COORD	LATITUDE	LONGITUDE
25	18N	6E	10	13A			X= Y=		



SCALE 1" = 40'


SHEET ___ OF ___ SHEETS

Tied by: LP: JB Date: 8/16/95
 Drawn by: BH/1 Date: 8/25/95
 Checked by: M.C. P.W. Date: 7-28-03


DESCRIPTION OF MONUMENT

Chiseled "X" in stone 1' below casting, 2' below surface of asphalt road

Iron Pipe in 6"x6" Square Casting in Concrete flush w/ Asphalt Rd.

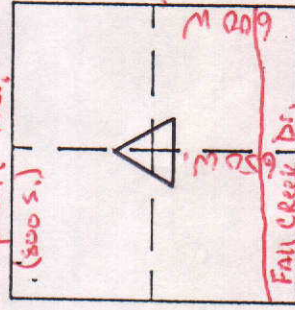

MARKER LOCATION

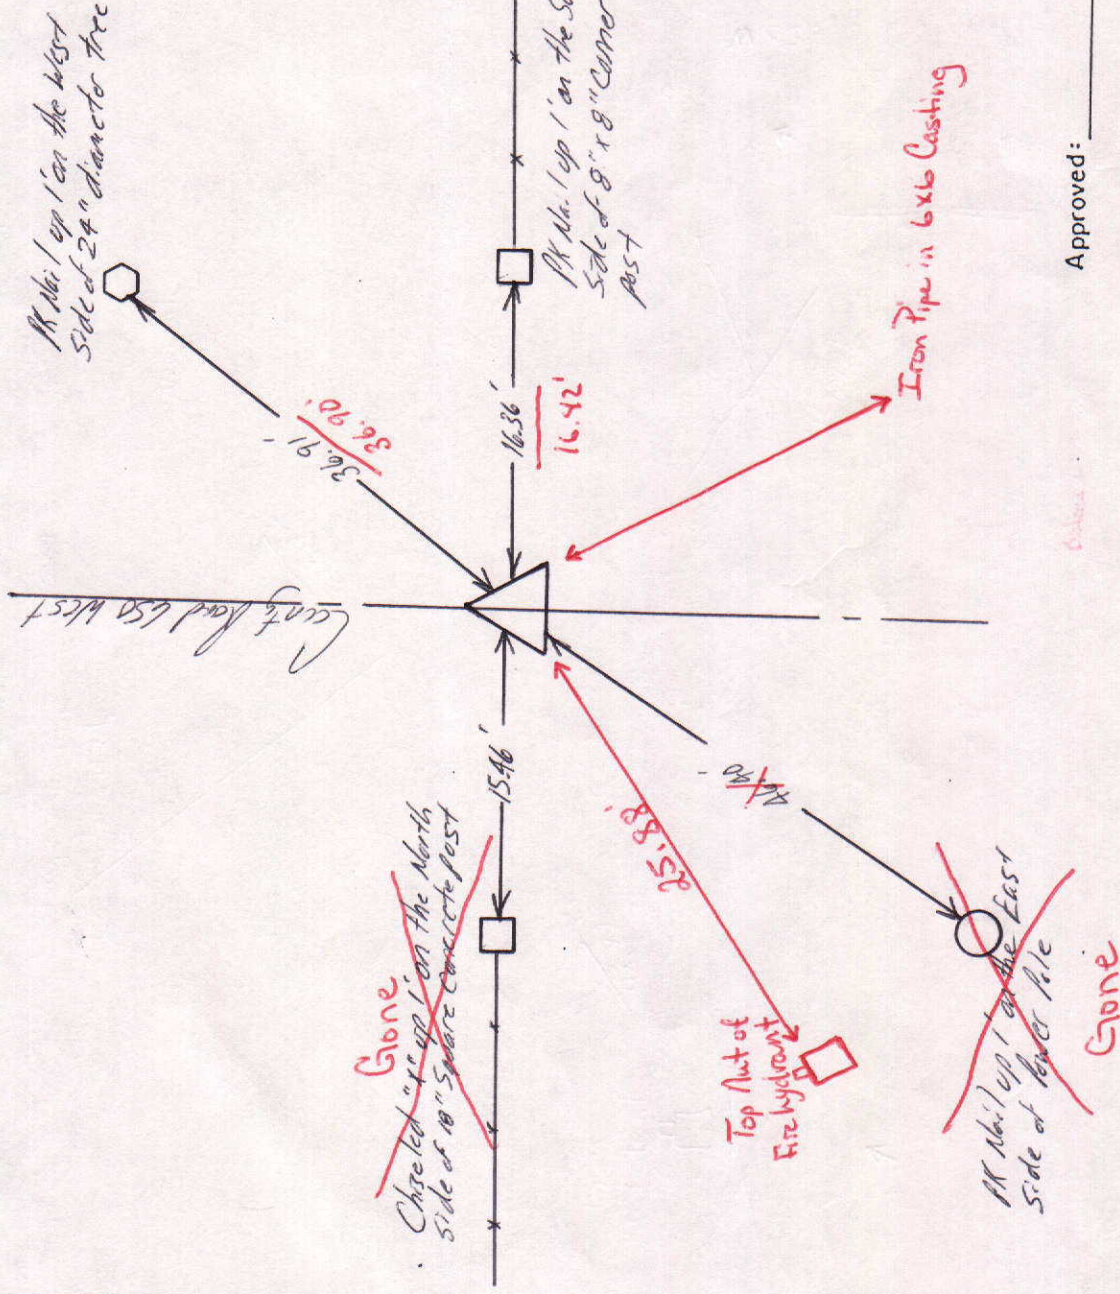

Approved: _____

Date: _____

COUNTY SURVEYOR

COUNTY SURVEYOR'S - SECTION CORNER TIES

SECTION	TOWNSHIP	RANGE	BOOK	PAGE	ELEVATION	UC ZONE	STATE PLANE COORD	LATITUDE	LONGITUDE
25	18N	6E	10	13B			X=	Y=	

PK Nail 1' up on the West side of River Rd

~~PK Nail 1' up on the South Side of River Rd~~

(new Pole)

Set P.K. Nail 1' up on South West Side of P.P.

Set P.K. Nail 1' up on North Side of P.P.

(new Pole) 48.47'

62.16'

61.68'

1/2" Iron Pipe

Fall Creek Drive

PK Sp. to Flash pt. to Surface of asphalt Road

1/2" Iron Pipe Below 6' x 6' Casing

~~PK Nail 1' up on the West Side of Telephone pole~~

Gone



NORTH

SCALE 1" = 40'

SHEET ___ OF ___ SHEETS


Tied by: LP:JB Date: 8/16/95

Drawn by: BHL Date: 8/25/95

Checked by: MC-RW Date: 7-28-03

DESCRIPTION OF MONUMENT

1/2" Iron Pipe .2' below Surface of asphalt Road
 1/2" Iron Pipe Below Surface 5" of Asphalt Rd

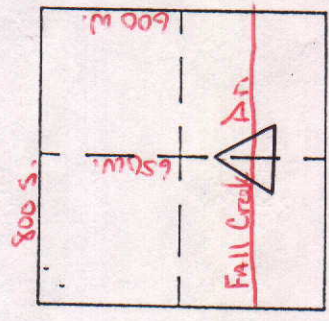

MARKER LOCATION

Approved:

Date:

COUNTY SURVEYOR