


SEC. 22, TWP. 19N, R.7 E.

SEE 15, 19, 7

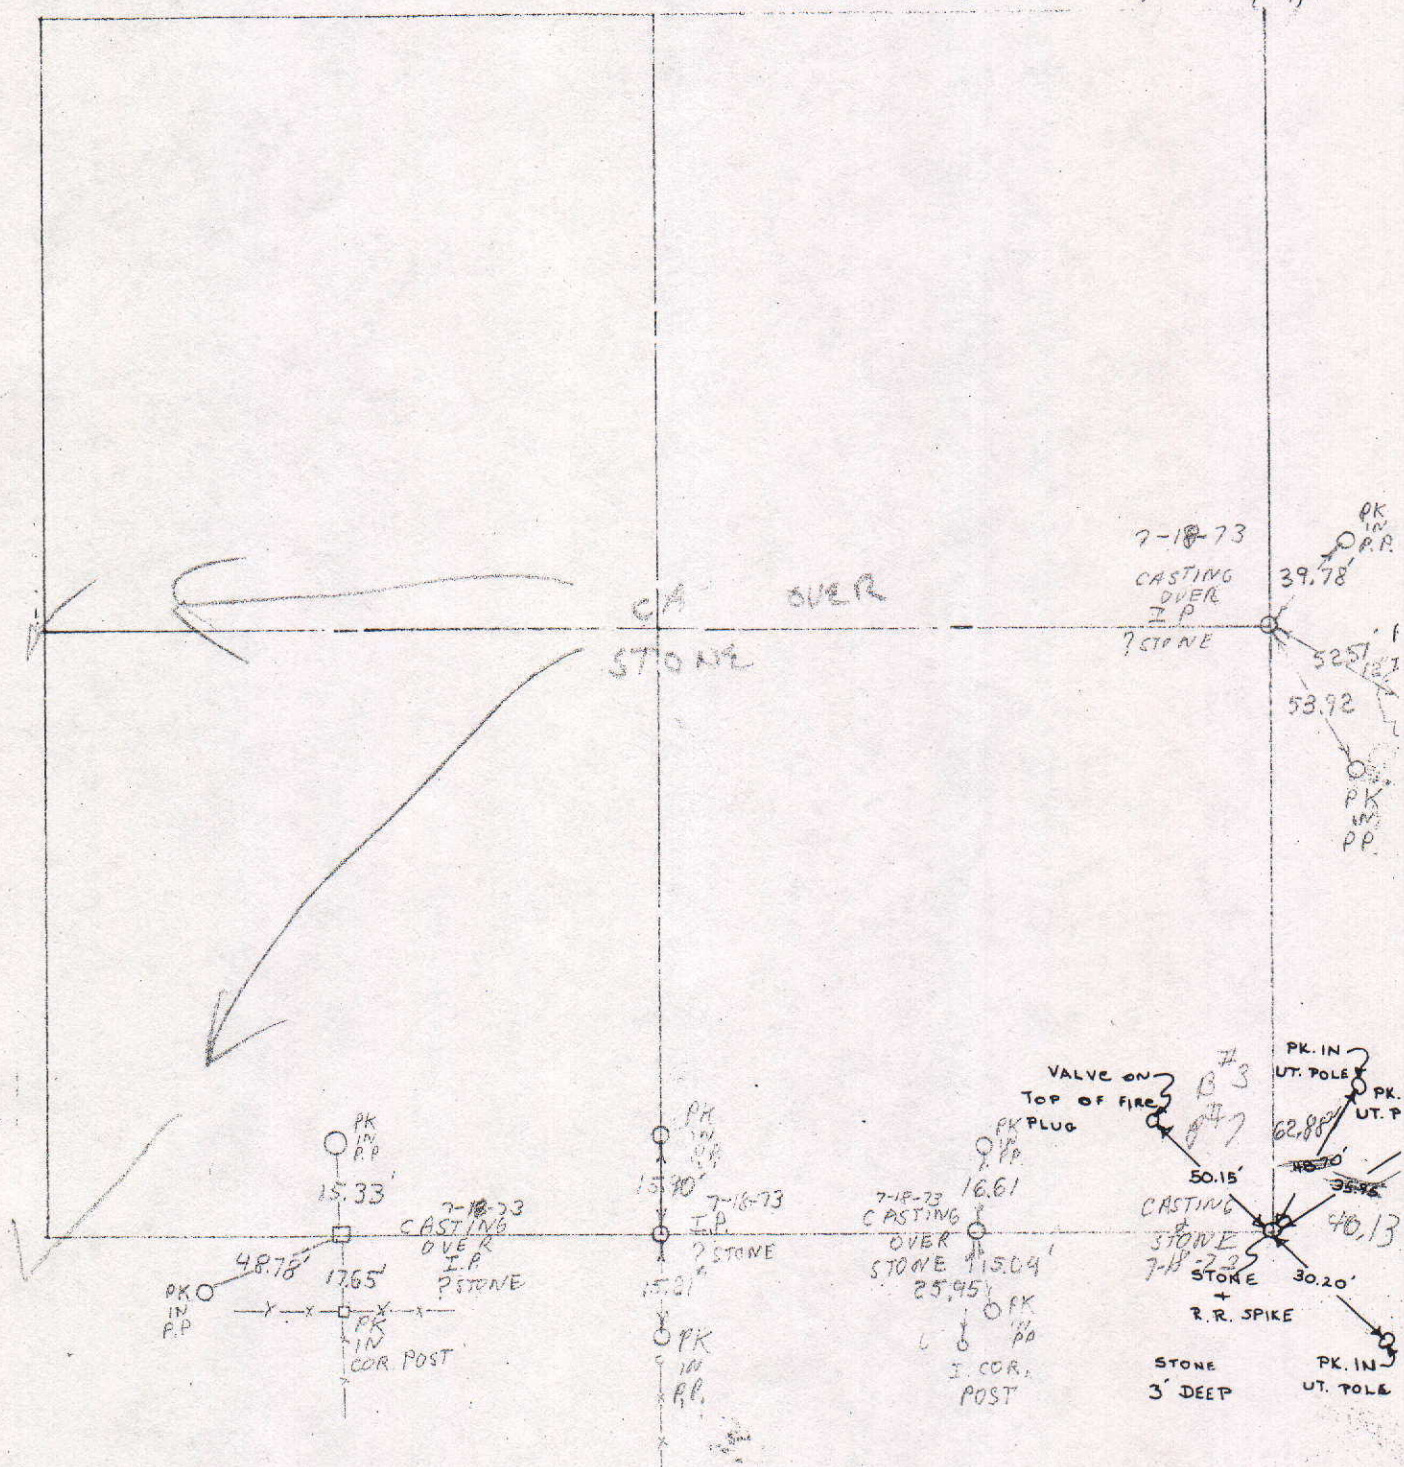


COUNTY SURVEYOR'S - SECTION CORNER TIES

SECTION	TOWNSHIP	RANGE	BOOK	PAGE	ELEVATION	UC ZONE	STATE PLANE COORD	LATITUDE	LONGITUDE
22	19	7				X=	Y=		




P.K. NAIL IN ~~WEST~~ EAST
SIDE OF T.P.

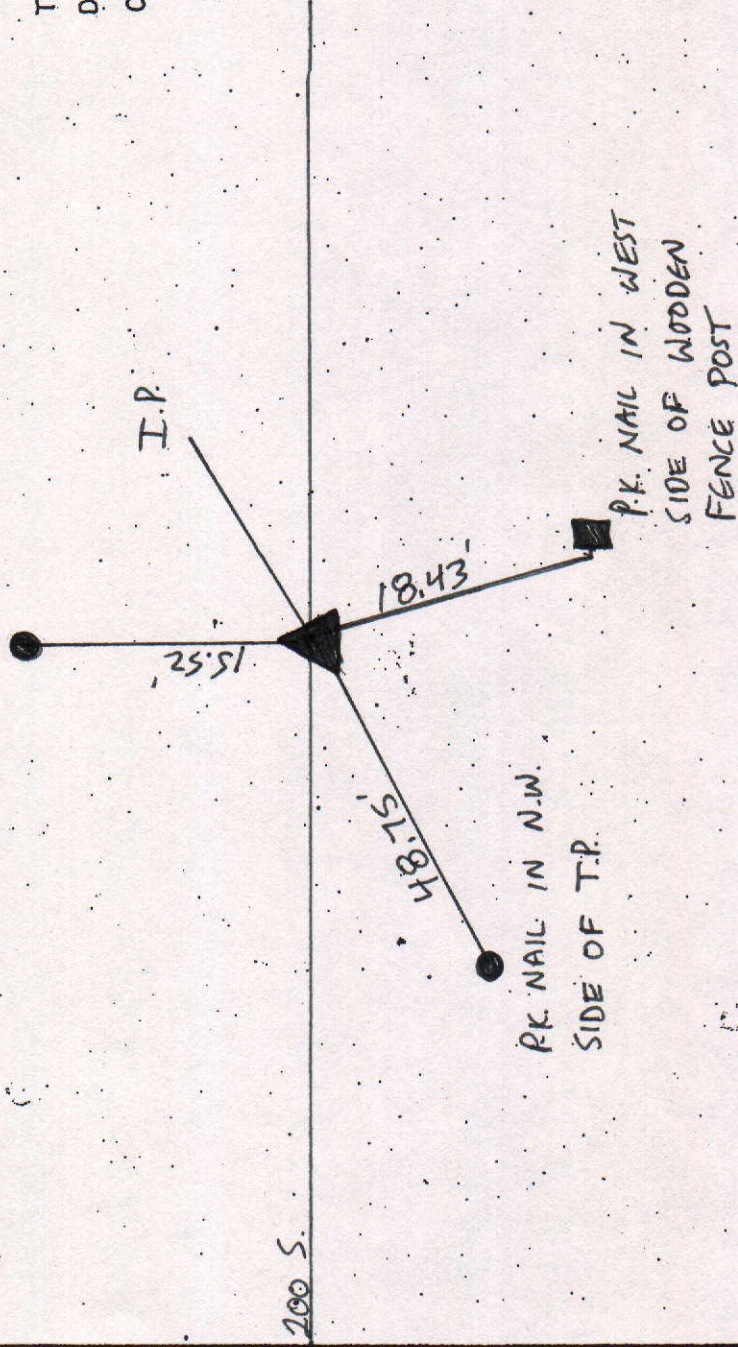

Tied by: RW/MC Date:
 Drawn by: RW Date: 9/27/04
 Checked by: Date:

DESCRIPTION OF MONUMENT

Iron Pipe in 4" x 4"
 Casting 8" Below
 Asphalt Road

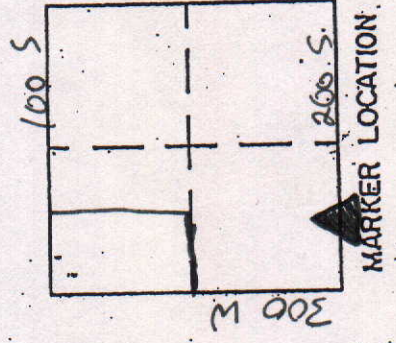

Date:

COUNTY SURVEYOR'S - SECTION CORNER TIES

SECTION	TOWNSHIP	RANGE	BOOK	PAGE	ELEVATION	UC ZONE	STATE PLANE COORD	LATITUDE	LONGITUDE
22	19	7					X=	Y=	



P.K. NAIL IN N.E. OF P.P.
P.K. NAIL IN S.E. SIDE OF T.P.




200 S.

DESCRIPTION OF MONUMENT

Railroad Spike in Concrete,
flush w/ Asphalt Road

Tied by: RW/ME Date: 9/27/04
 Drawn by: RW Date: 9/27/04
 Checked by: Date:

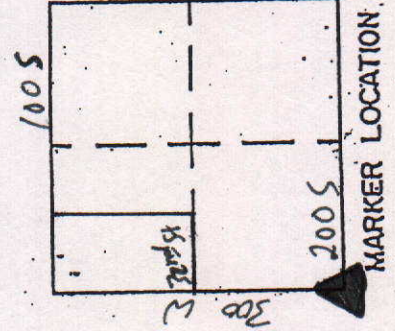

P.K. NAIL IN N.W. SIDE OF T.P.

R.R. Spike

300 W.

MARKER LOCATION


Date:

COUNTY SURVEYOR'S - SECTION CORNER TIES

SECTION	TOWNSHIP	RANGE	BOOK	PAGE	ELEVATION	UC ZONE	STATE PLANE COORD	LATITUDE	LONGITUDE
22	19	7					X=	Y=	




P.K. NAIL IN WEST SIDE
OF T.P.

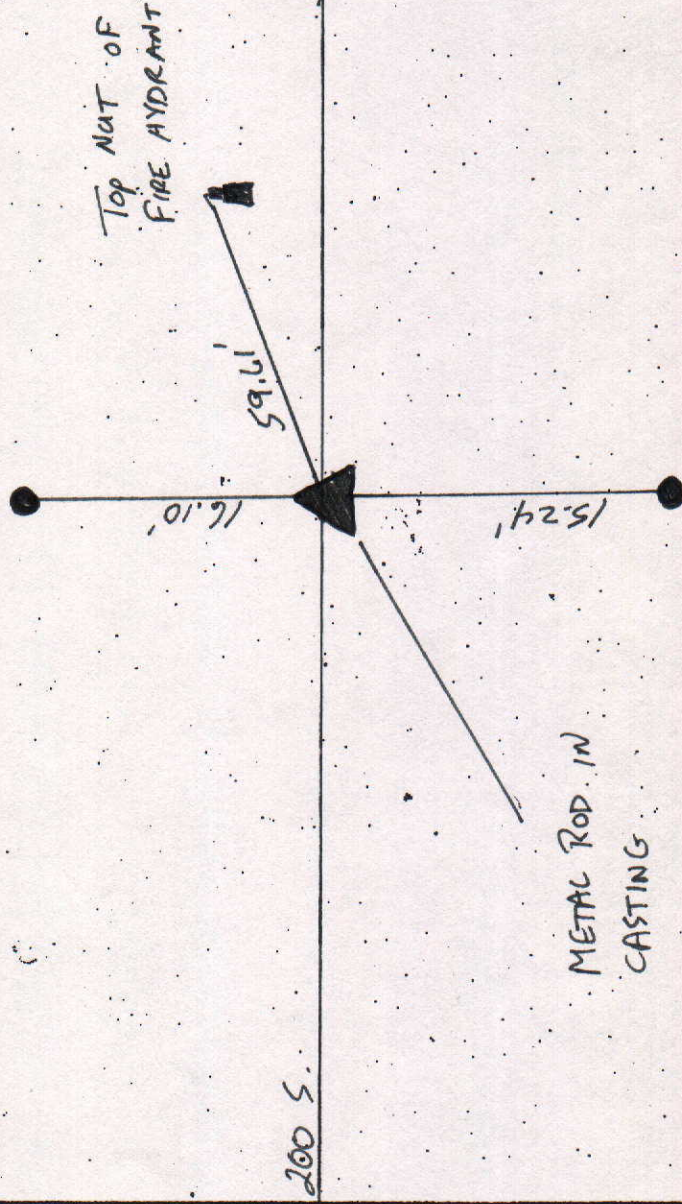

Tied by: RW/MC Date: 9/27/04
 Drawn by: RW Date: 9/27/04
 Checked by: _____ Date: _____


DESCRIPTION OF MONUMENT

METAL ROD ~~IN CASTING~~
 1' BELOW CASTING flush
 w/ Asphalt Road

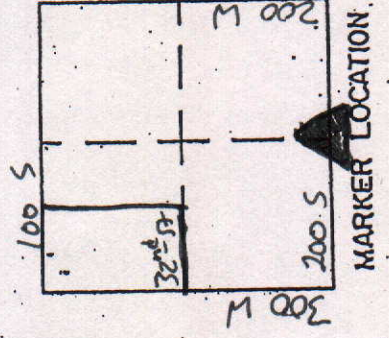

COUNTY SURVEYOR'S - SECTION CORNER TIES


SECTION	TOWNSHIP	RANGE	BOOK	PAGE	ELEVATION	UC ZONE	STATE PLANE COORD	LATITUDE	LONGITUDE
22	19	7					X=	Y=	

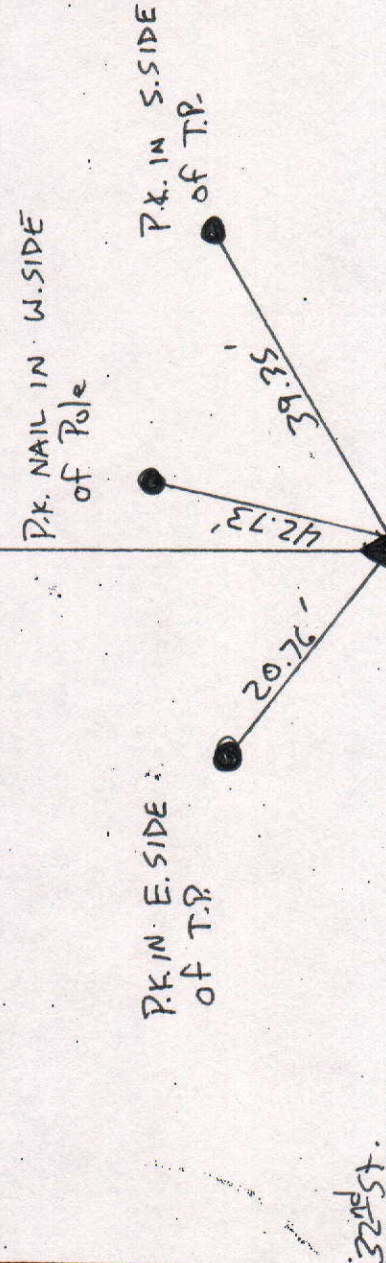

Tied by: RWMC Date: 9/22/04
 Drawn by: RW Date: 9/23/04
 Checked by: _____ Date: _____

DESCRIPTION OF MONUMENT

Railroad Spike in Concrete
Flush w/ Asphalt Road

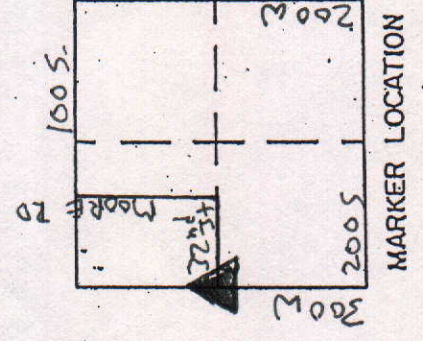


COUNTY SURVEYOR'S - SECTION CORNER TIES

SECTION	TOWNSHIP	RANGE	BOOK	PAGE	ELEVATION	UC ZONE	STATE PLANE COORD	LATITUDE	LONGITUDE
22	19N	7E					X= Y=		

 NORTH
 SCALE 1" = 40'
 SHEET ___ OF ___ SHEETS

Tied by: _____ Date: _____
 Drawn by: BAN Date: 3-23-93
 Checked by: _____ Date: _____


DESCRIPTION OF MONUMENT

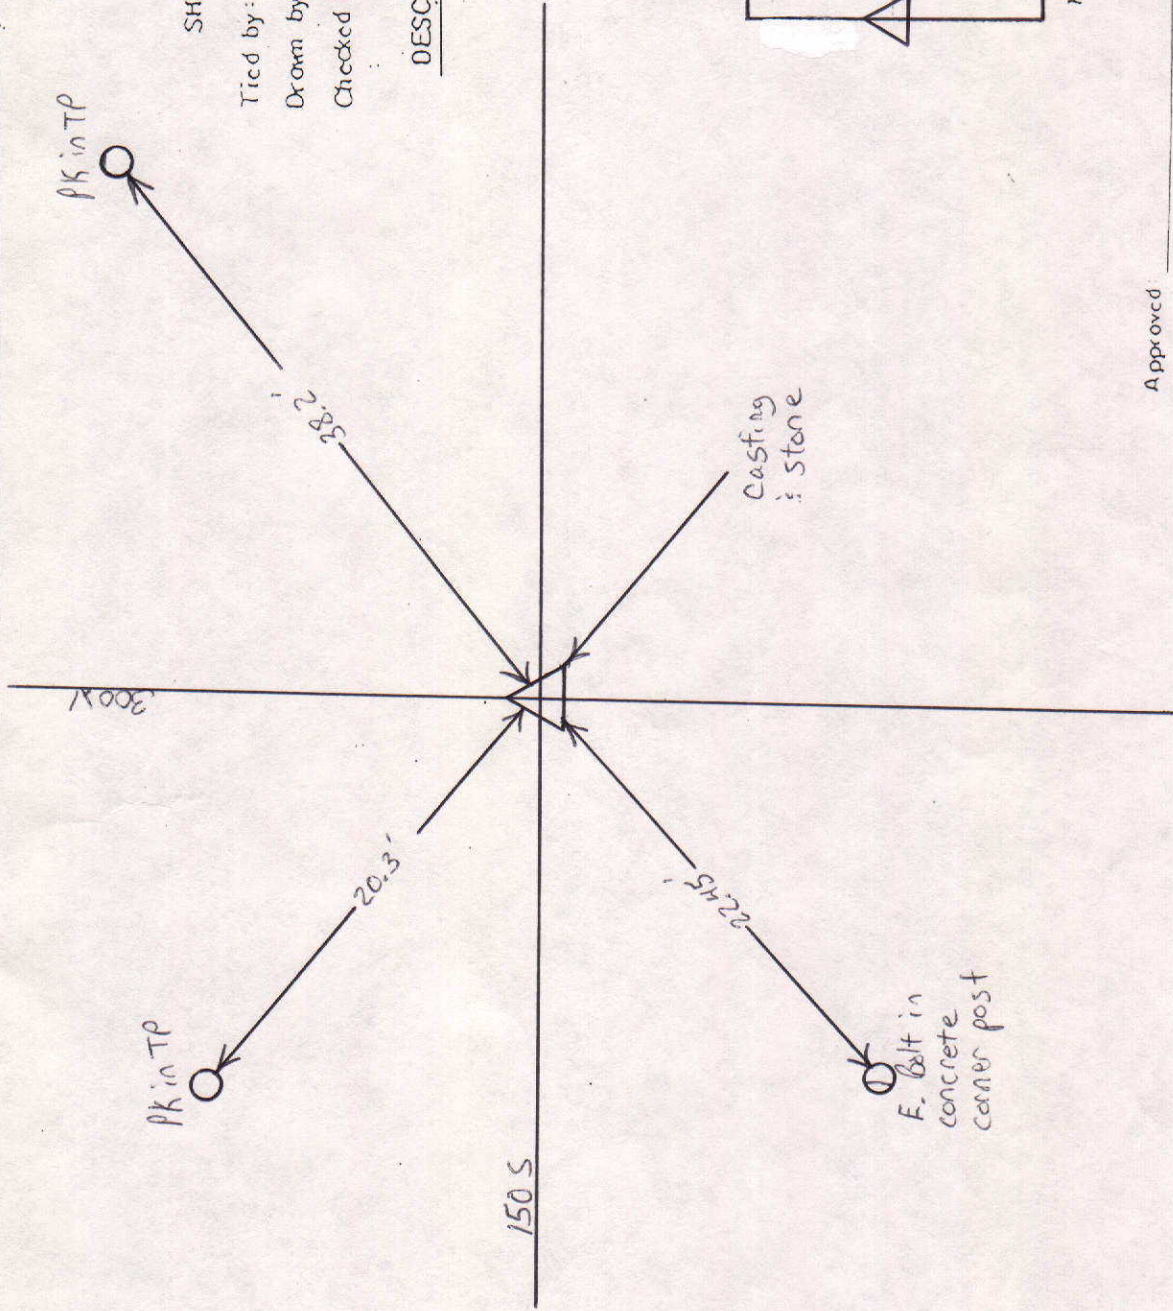

Approved _____ Date: _____
 COUNTY SURVEYOR

COUNTY SURVEYOR'S - SECTION CORNER TIES

SECTION	TOWNSHIP	RANGE	BOOK	PAGE	ELEVATION	UC ZONE	STATE PLANE COORD	LATITUDE	LONGITUDE
22	19N	7E	7	8A			X= Y=		

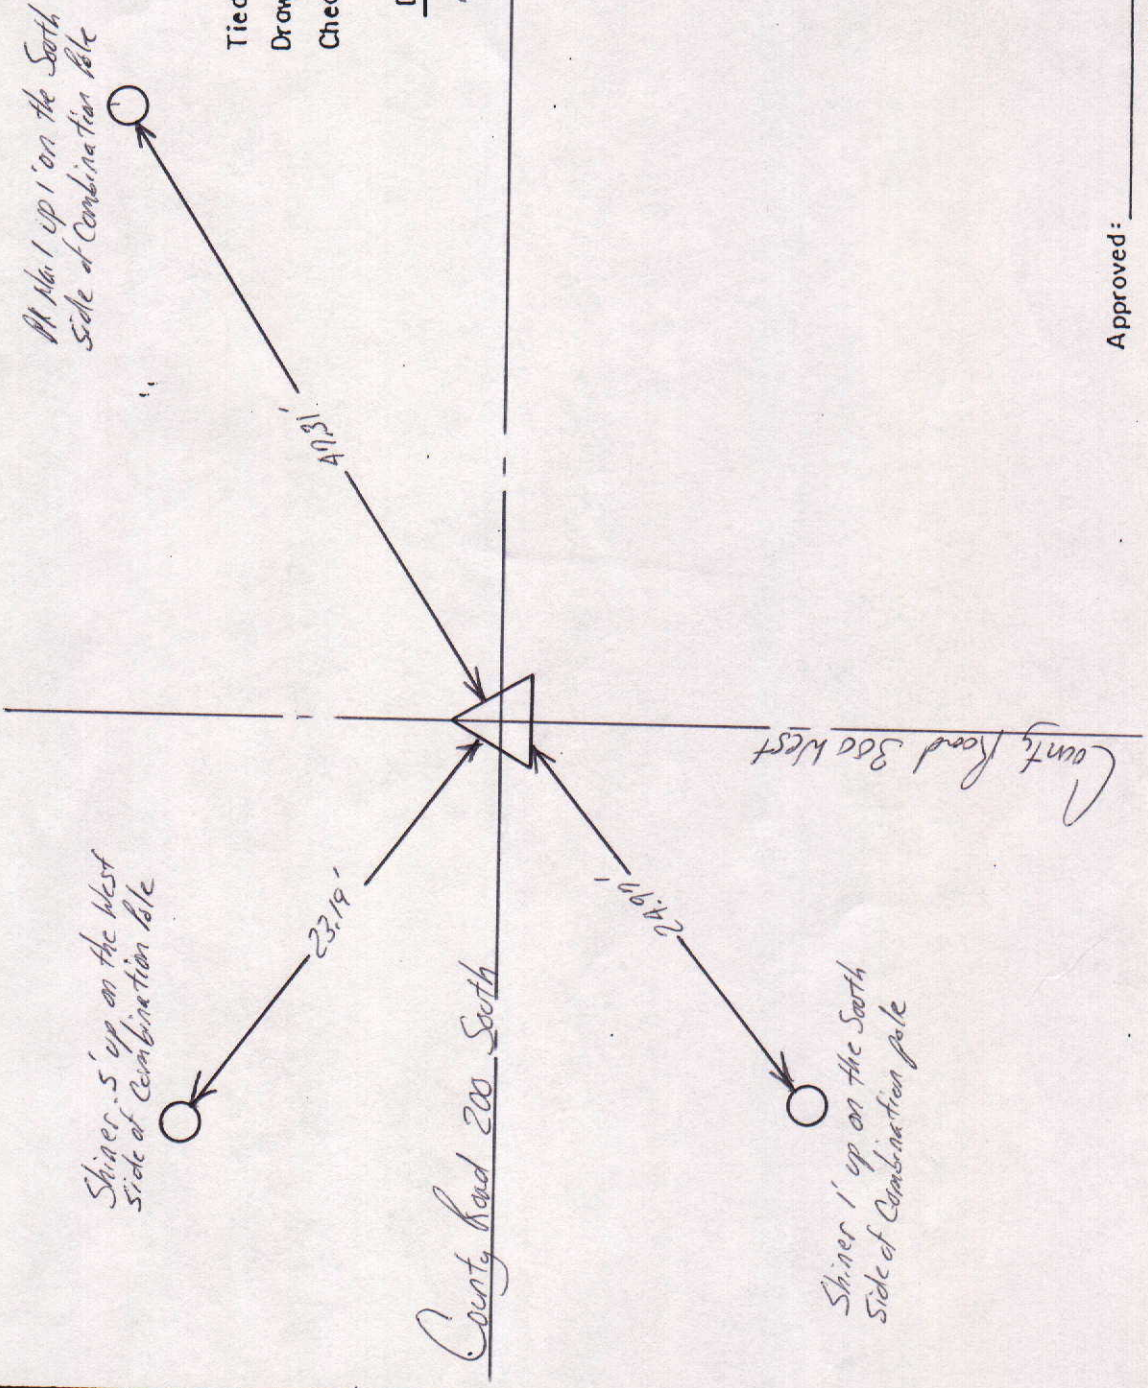

NORTH

SCALE 1" = 40'

SHEET ___ OF ___ SHEETS


Tied by: L.R. & J.B. Date: 7/12/95

Drawn by: B.A.W. Date: 8/15/95

Checked by: _____ Date: _____

DESCRIPTION OF MONUMENT

RR spike in concrete flush with surface of asphalt road

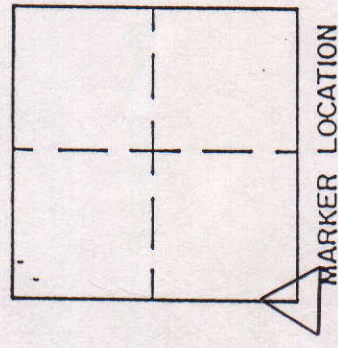

MARKER LOCATION

Approved: _____ Date: _____

COUNTY SURVEYOR



COUNTY SURVEYOR'S - SECTION CORNER TIES

SECTION	TOWNSHIP	RANGE	BOOK	PAGE	ELEVATION	UC ZONE	STATE PLANE COORD	LATITUDE	LONGITUDE
22	19	7				X=	Y=		

 NORTH
 SCALE 1" = 40'
 SHEET ___ OF ___ SHEETS

Tied by: _____ Date: _____
 Drawn by: BAN Date: 2-23-93
 Checked by: _____ Date: _____

DESCRIPTION OF MONUMENT

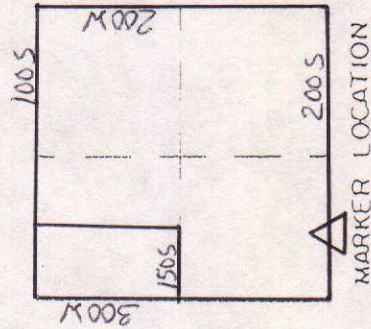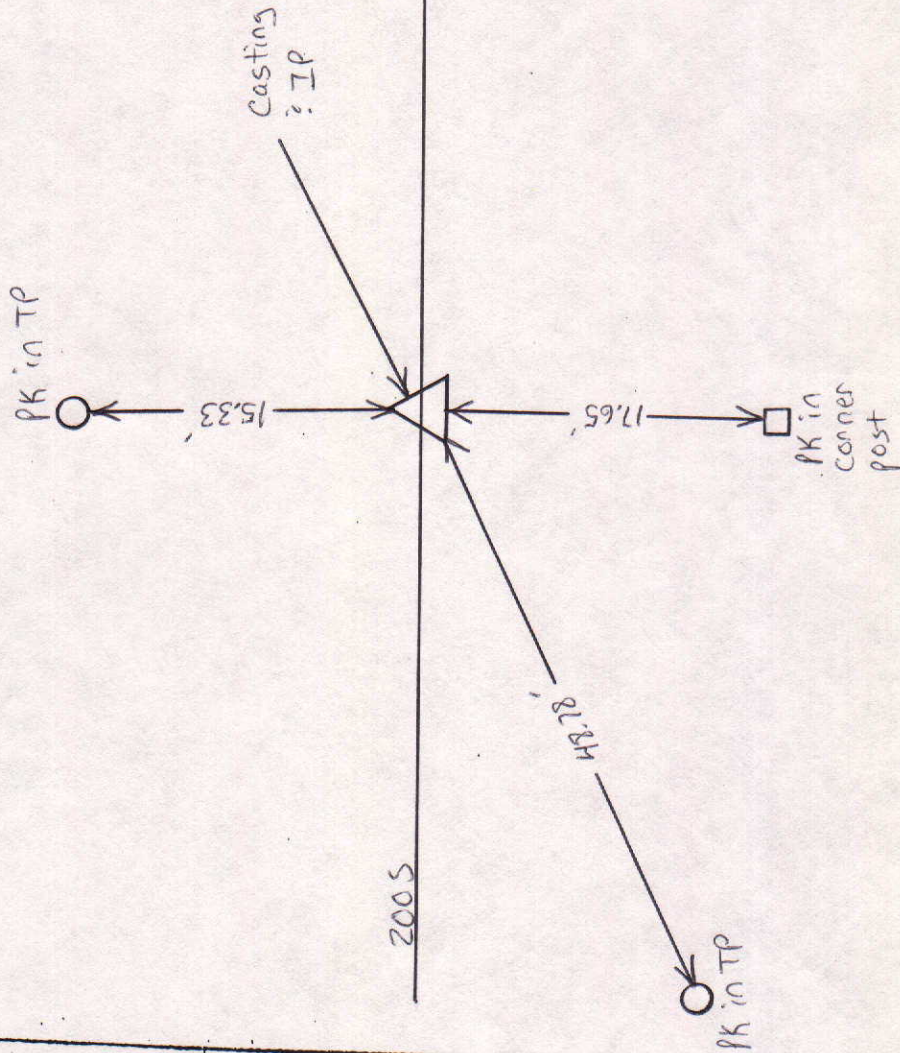

Approved: _____ Date: _____
 COUNTY SURVEYOR

COUNTY SURVEYOR'S - SECTION CORNER TIES

SECTION	TOWNSHIP	RANGE	BOOK	PAGE	ELEVATION	UC ZONE	STATE PLANE	COORD	LATITUDE	LONGITUDE
22	19N	7E						X=	Y=	



NORTH

SCALE 1" = 40'

SHEET ___ OF ___ SHEETS



Tied by: J.S. & D.S. Date: 8-8-91

Drawn by: J.S. Date: 8-9-91

Checked by: _____ Date: _____

DESCRIPTION OF MONUMENT

Nail at the NW corner of the NE 1/4 of 27-19-7

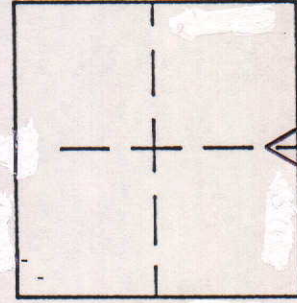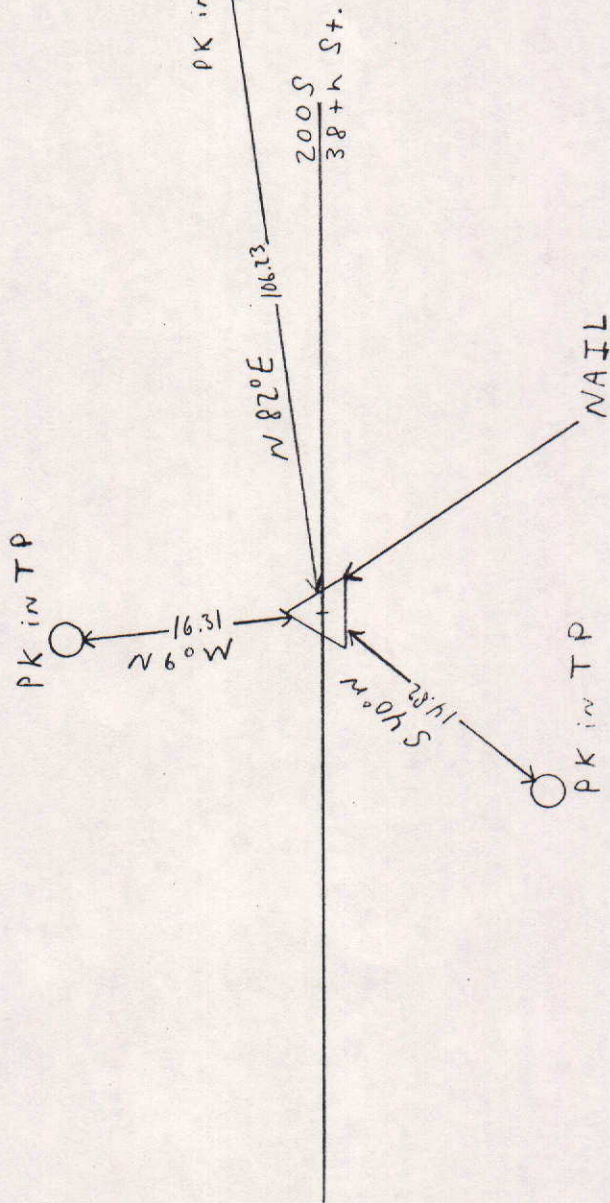

MARKER LOCATION

Approved: _____ Date: _____

COUNTY SURVEYOR

COUNTY SURVEYOR'S - SECTION CORNER TIES

SECTION	TOWNSHIP	RANGE	BOOK	PAGE	ELEVATION	UC ZONE	STATE PLANE	COORD	LATITUDE	LONGITUDE
22	19	7				X=	Y=			




SCALE 1" = 40'

SHEET ___ OF ___ SHEETS

Tied by: _____ Date: _____
 Drawn by: BAN Date: 2-23-93
 Checked by: _____ Date: _____

DESCRIPTION OF MONUMENT

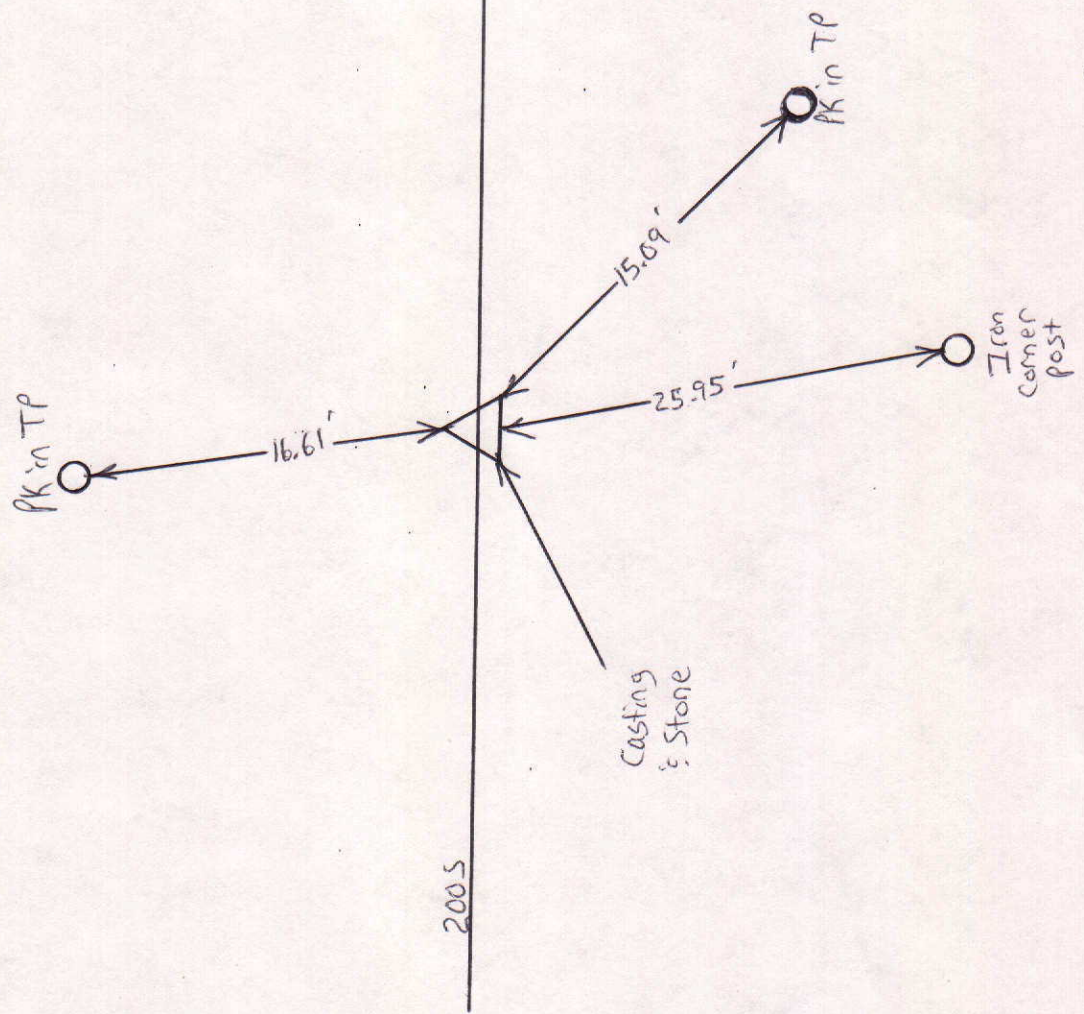

Approved: _____ Date: _____
 COUNTY SURVEYOR

COUNTY SURVEYOR'S - SECTION CORNER TIES

SECTION	TOWNSHIP	RANGE	BOOK	PAGE	ELEVATION	UC ZONE	STATE PLANE COORD	LATITUDE	LONGITUDE
22	19	7				X=	Y=		

100 S. (25th St.)



P.K. Nail N.E. Side of P.P. 33.78'

P.K. Nail N.W. Side of P.P. 104.00'



DESCRIPTION OF MONUMENT


P.K. Nail flush w/ Asphalt

Driveway
P.K. Nail N.E. Side of P.P. 51.67'

P.K. Nail flush w/ Asphalt - Center of Road.

Park Rd. (300 ft.)

200 S. (38th St.)

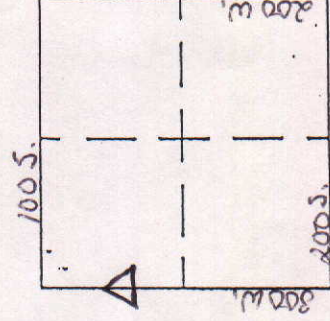

MARKER LOCATION

Tied by: M.C. - E.W. Date: 5-14-03
Drawn by: M.E. Date: 5-15-02
Checked by: Date:

Approved:

COUNTY SURVEYOR

Date: